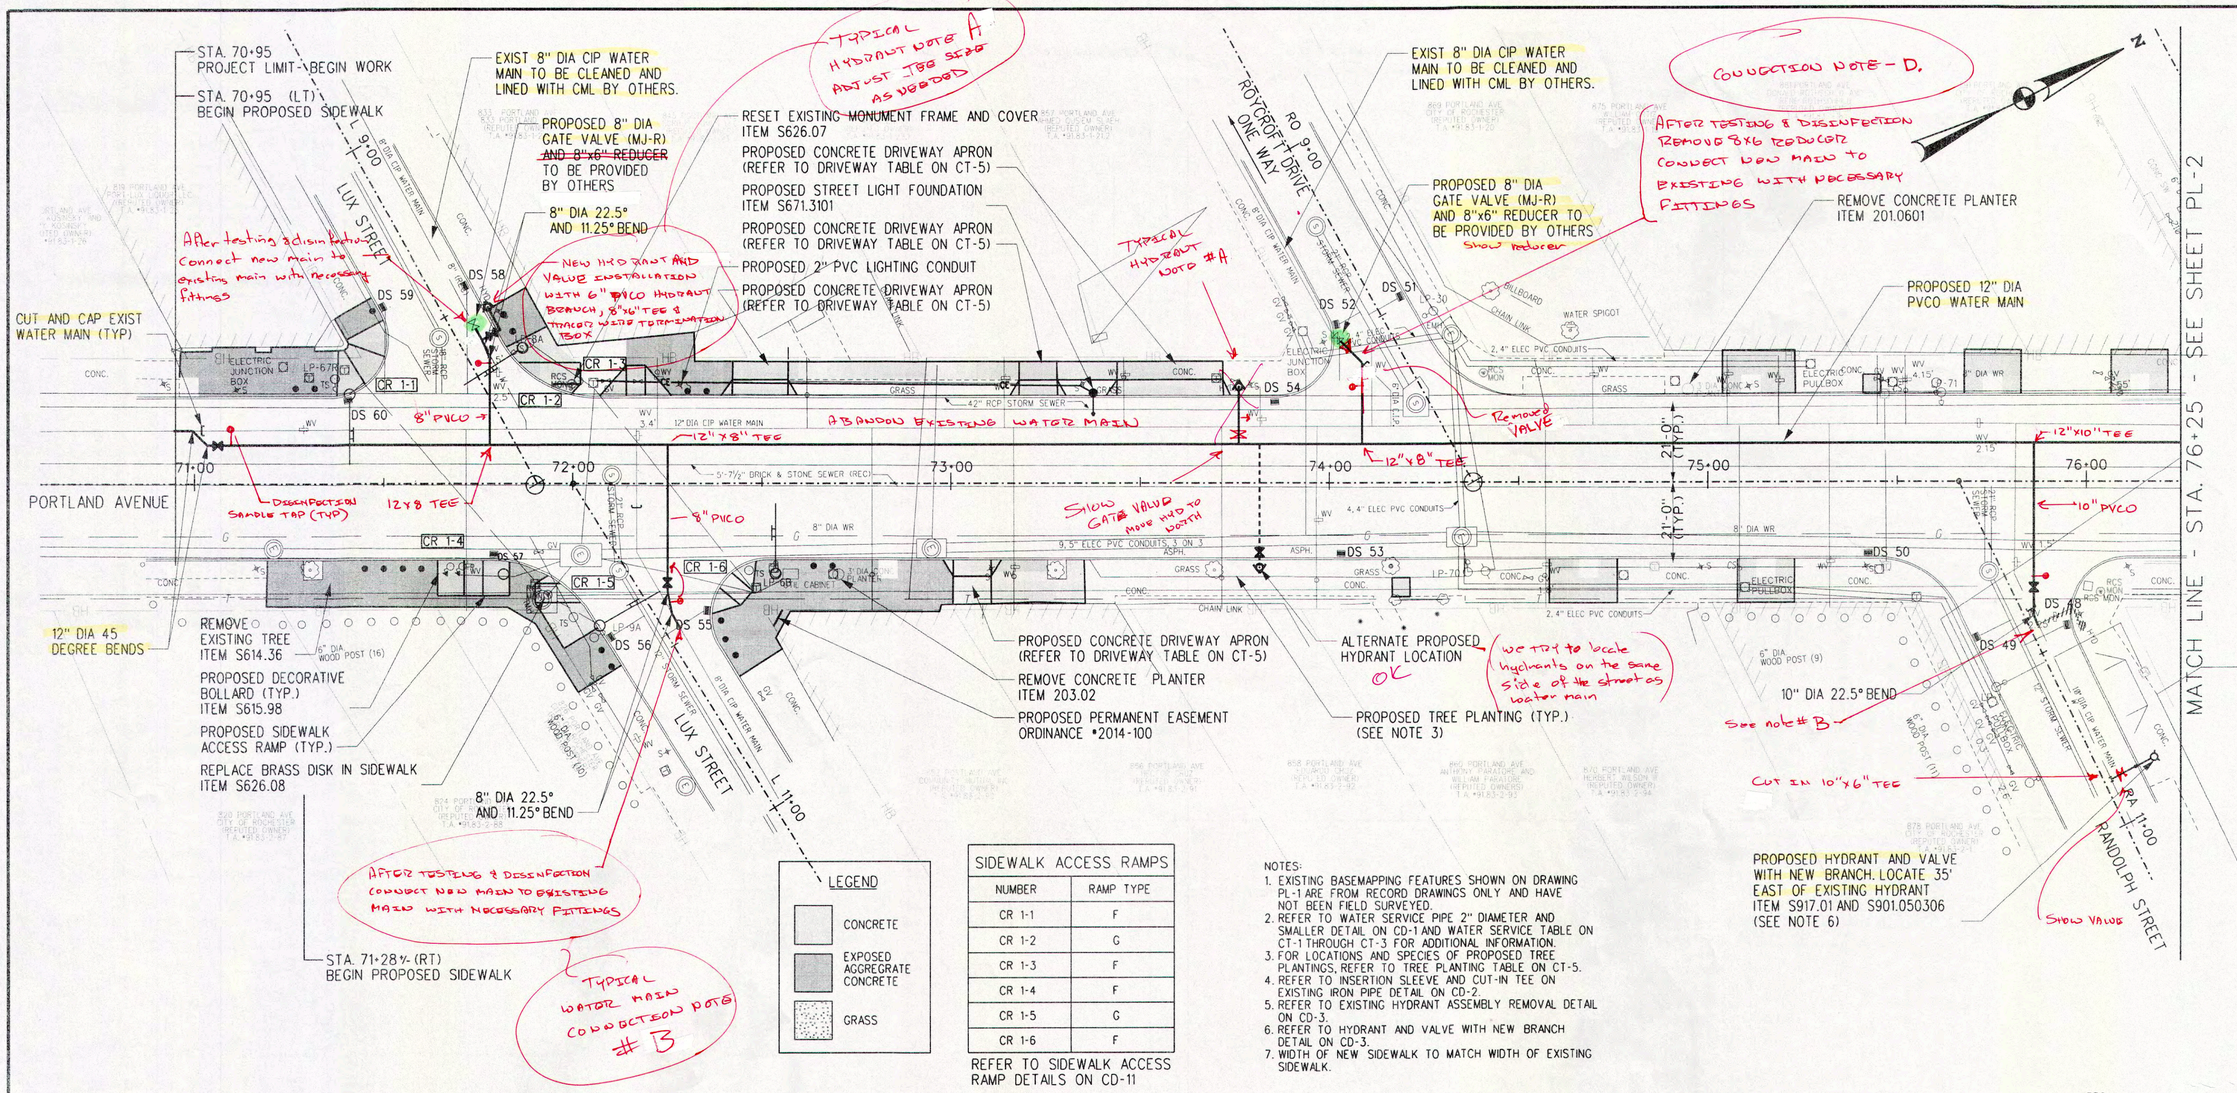

SIDEWALK ACCESS RAMPS	
NUMBER	RAMP TYPE
CR 1-1	F
CR 1-2	G
CR 1-3	F
CR 1-4	F
CR 1-5	G
CR 1-6	F

REFER TO SIDEWALK ACCESS RAMP DETAILS ON CD-11

NOTES:
1. EXISTING BASEMAPPING FEATURES SHOWN ON DRAWING PL-1 ARE FROM RECORD DRAWINGS ONLY AND HAVE NOT BEEN FIELD SURVEYED.
2. REFER TO WATER SERVICE PIPE 2" DIAMETER AND SMALLER DETAIL ON CD-1 AND WATER SERVICE TABLE ON CT-1 THROUGH CT-3 FOR ADDITIONAL INFORMATION.
3. FOR LOCATIONS AND SPECIES OF PROPOSED TREE PLANTINGS, REFER TO TREE PLANTING TABLE ON CT-5.
4. REFER TO INSERTION SLEEVE AND CUT-IN TEE ON EXISTING IRON PIPE DETAIL ON CD-2.
5. REFER TO EXISTING HYDRANT ASSEMBLY REMOVAL DETAIL ON CD-3.
6. REFER TO HYDRANT AND VALVE WITH NEW BRANCH DETAIL ON CD-3.
7. WIDTH OF NEW SIDEWALK TO MATCH WIDTH OF EXISTING SIDEWALK.

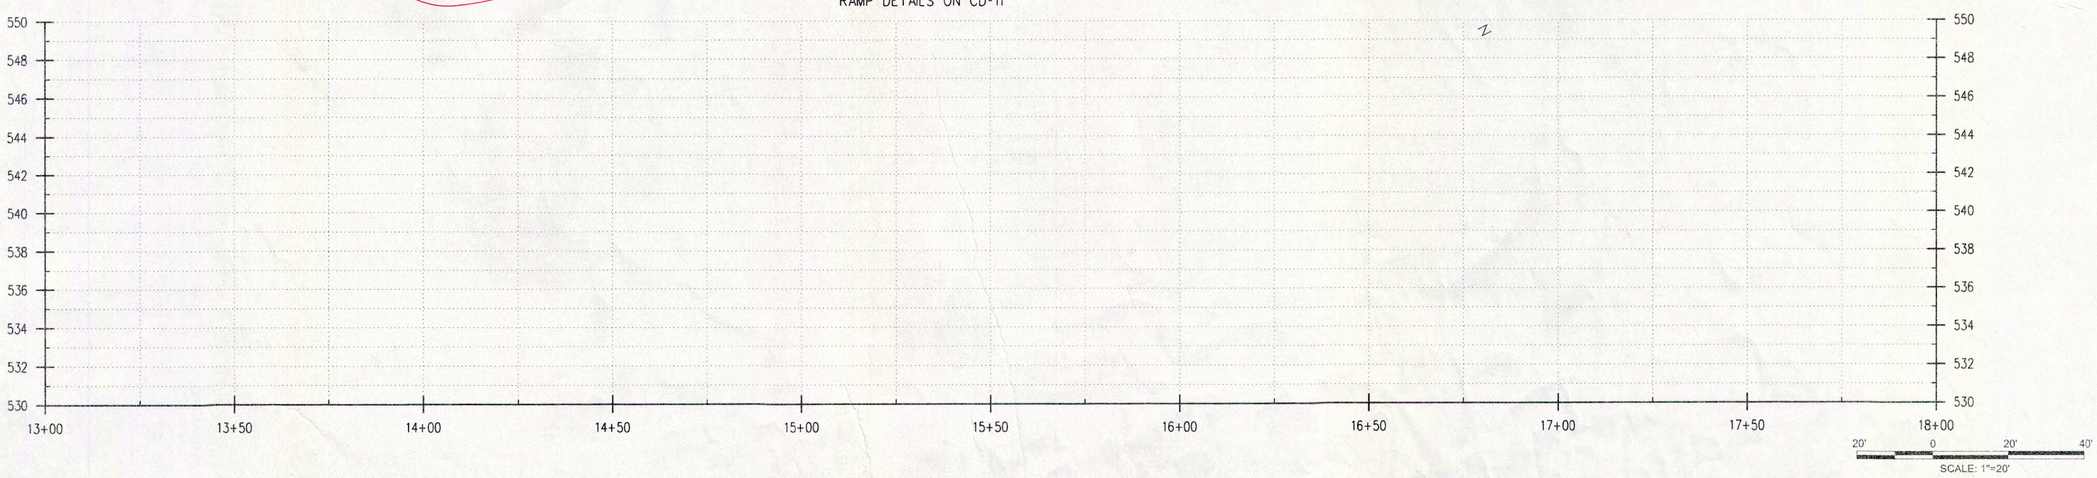

DATE: MAY 2015
SCALE: 1" = 20'
DESIGNED BY: PGW / CJL
DRAWN BY: KLO / MDZ

REVISIONS

NO	DATE	DESCRIPTION	BY

CITY OF ROCHESTER, NEW YORK
PORTLAND AVENUE REVITALIZATION

ROADWAY PLAN

COPYRIGHT © 2014
WENDEL

NO ALTERATION PERMITTED HEREON EXCEPT AS PROVIDED UNDER SECTION 7209 EDUCATION LAW, THE NEW YORK STATE EDUCATION DEPARTMENT. ALTERATIONS SHALL BE ACCOMPANIED BY THE SEAL AND SIGNATURE OF THE ENGINEER, LAND SURVEYOR, ARCHITECT, OR LANDSCAPE ARCHITECT MAKING SAID ALTERATION. ALL ALTERATIONS MUST BE "ALTERED BY" FOLLOWED BY A DESCRIPTION OF THE ALTERATIONS MADE.

wendel
100 Chestnut Street, Suite 1110
Rochester, NY 14604
www.wendelcompanies.com
(Wendel WD Architecture, Engineering, Surveying and Landscape Architecture P.C.

DRAWING NO.
PL-1
SHEET 32 OF 44
WENDEL JOB NUMBER
22134062